




PROFILE

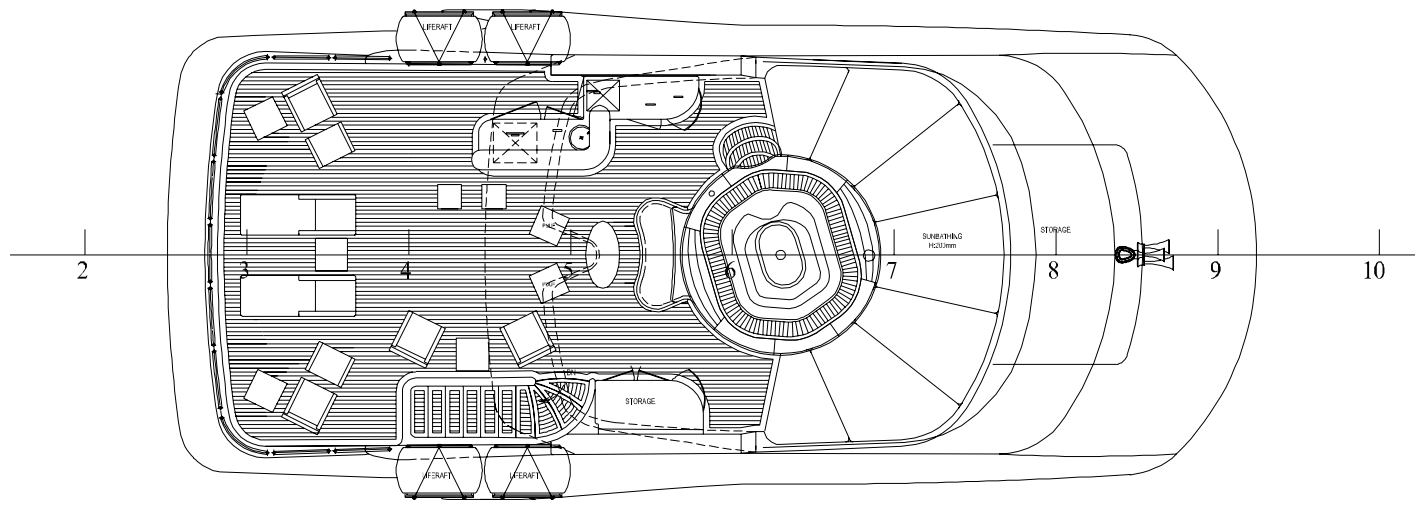


SUN DECK

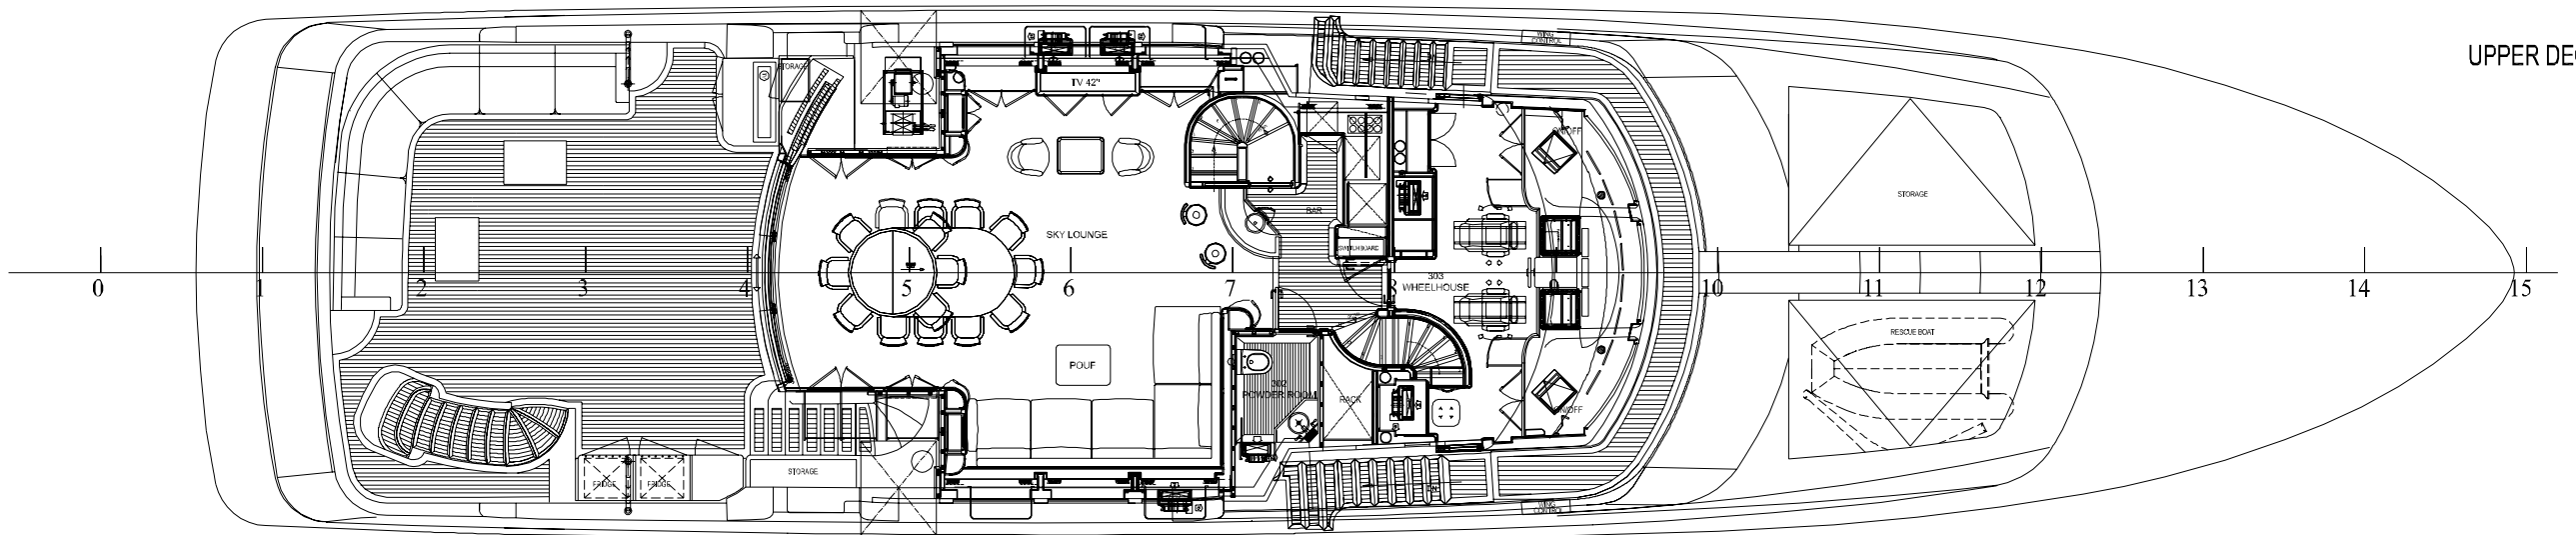

UPPER DECK

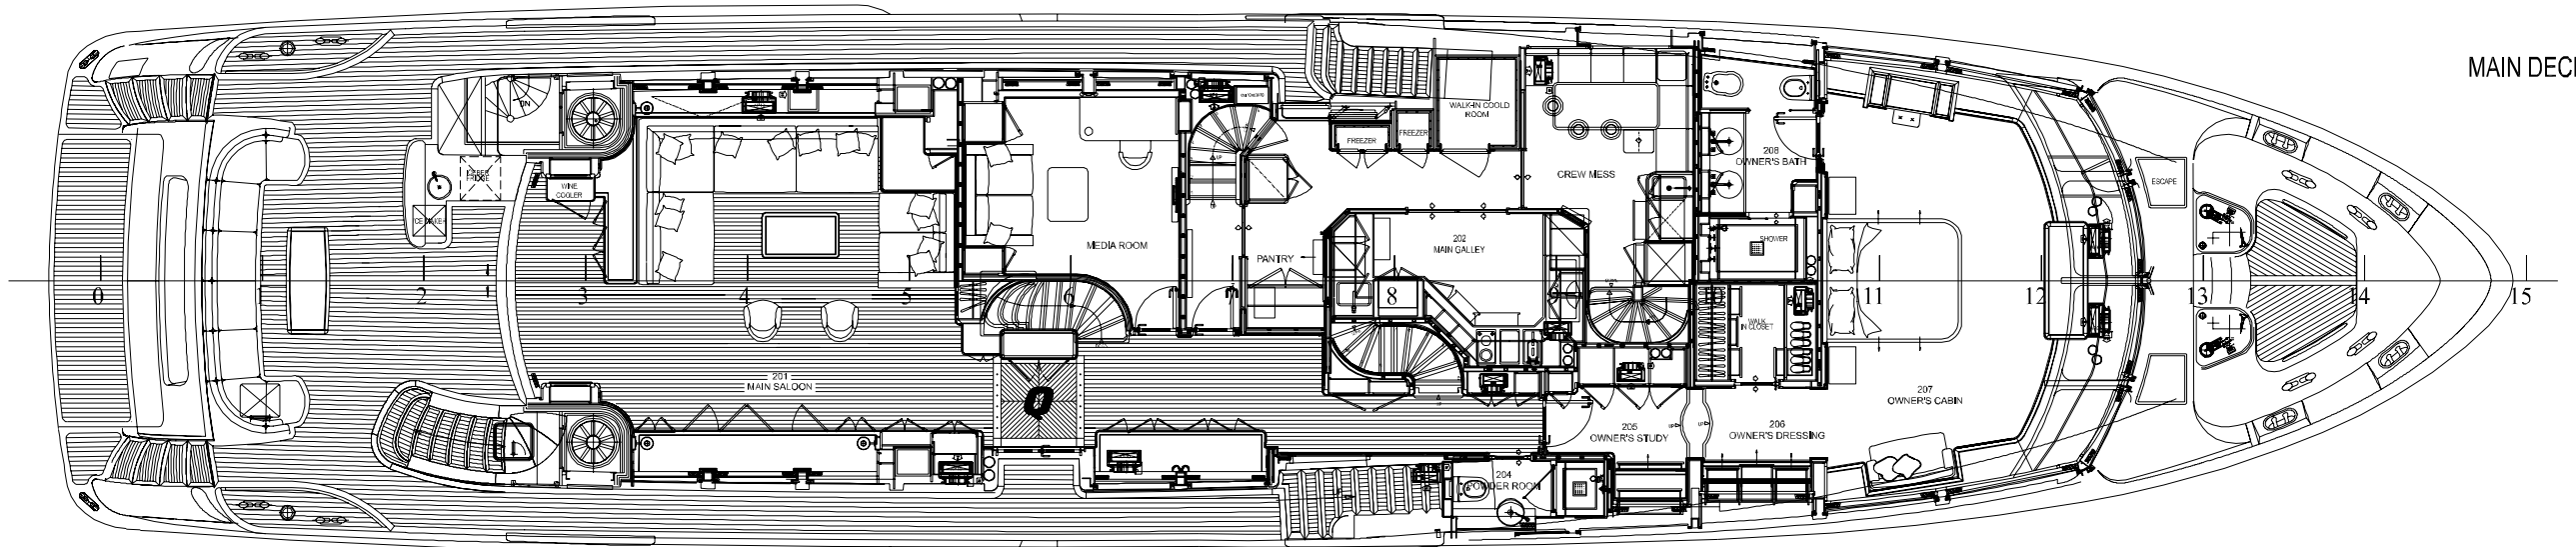

MAIN DECK

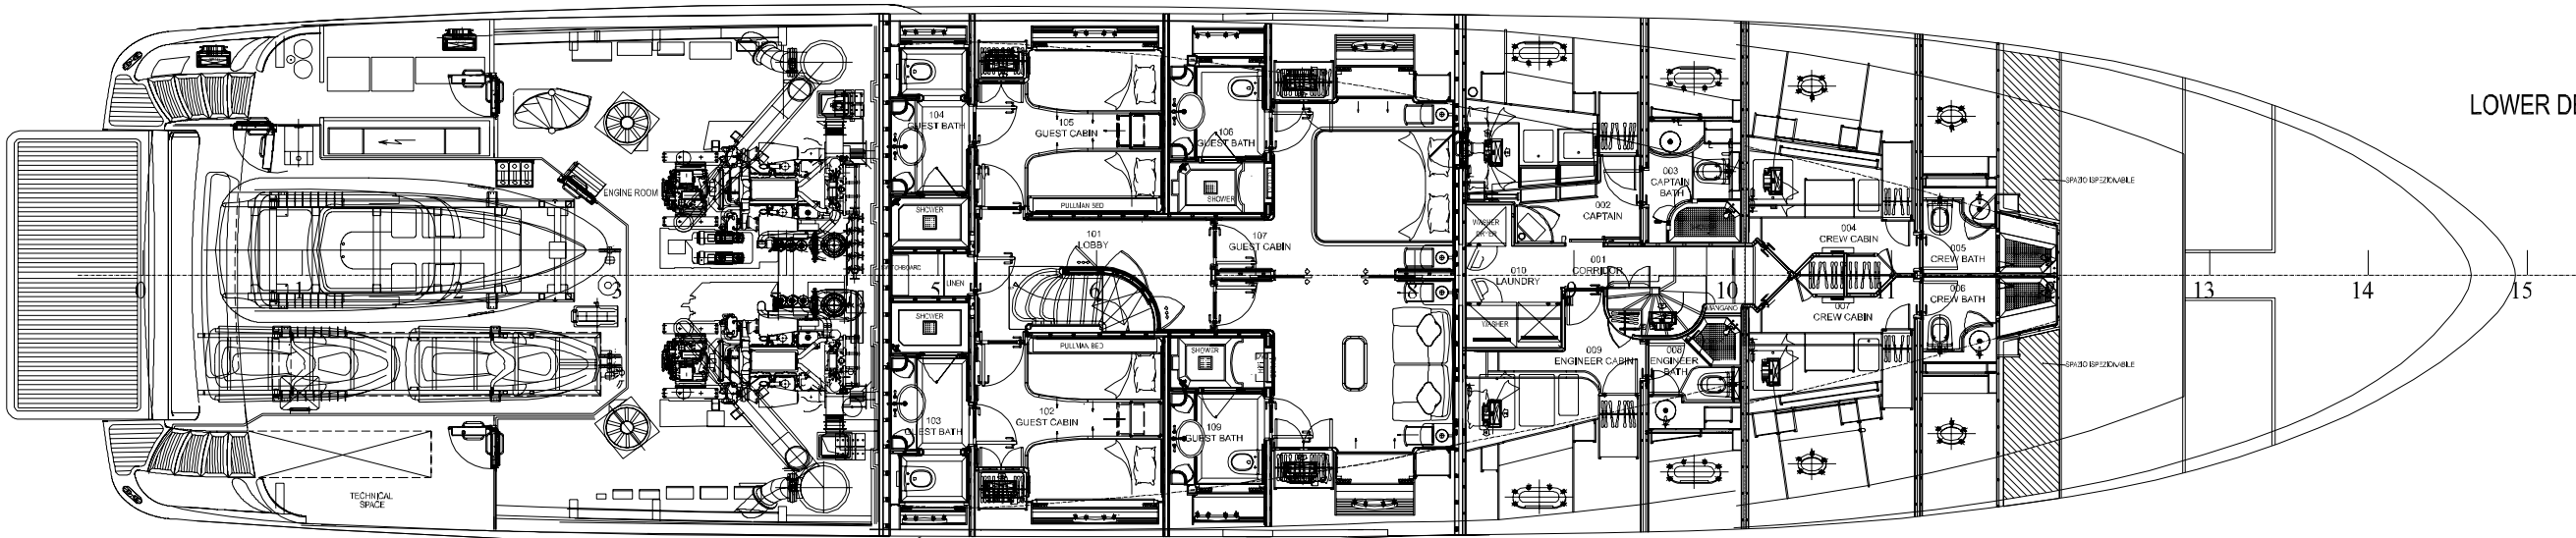

LOWER DECK

07	12/03/08	AS BUILT	PROSHIP (JB)
06	24/09/07	GENERAL REVIEW	PROSHIP (JB)
05	11/07/07	GENERAL REVIEW	P&A
04	28/05/07	GENERAL REVIEW	PROSHIP (JB)
03	27/04/07	GENERAL REVIEW	V.R.
02	27/03/07	EXTERNAL FURNITURE UPDATING	PROSHIP (JB)
01	29/01/07	GENERAL REVIEW	V.R.
00	30/11/06	OWNER'S REQUEST	M.G.
UPD	DATE	MODIFY DESCRIPTION	SIGNED

<p>VIA MARE COPPINI 04-55049 VIAREGGIO (LU) Italy Tel. +39-0584-3801 Fax +39-0584-380232</p>	CONSTRUCTION	DRAWING N°	UPDATING	SHEET	OF
	BC112	C112 0101	07	01	01
DESCRIPTION	GENERAL ARRANGEMENT				DRAWN BY
	AS BUILT				P&A
					CHECKED BY
					APPROVED BY
E' vietata la riproduzione anche parziale e la consegna a terzi di questo disegno Reproduction of this drawing or assignment to a third party is prohibited				SCALE	DATE
				1:75	05/07/06